


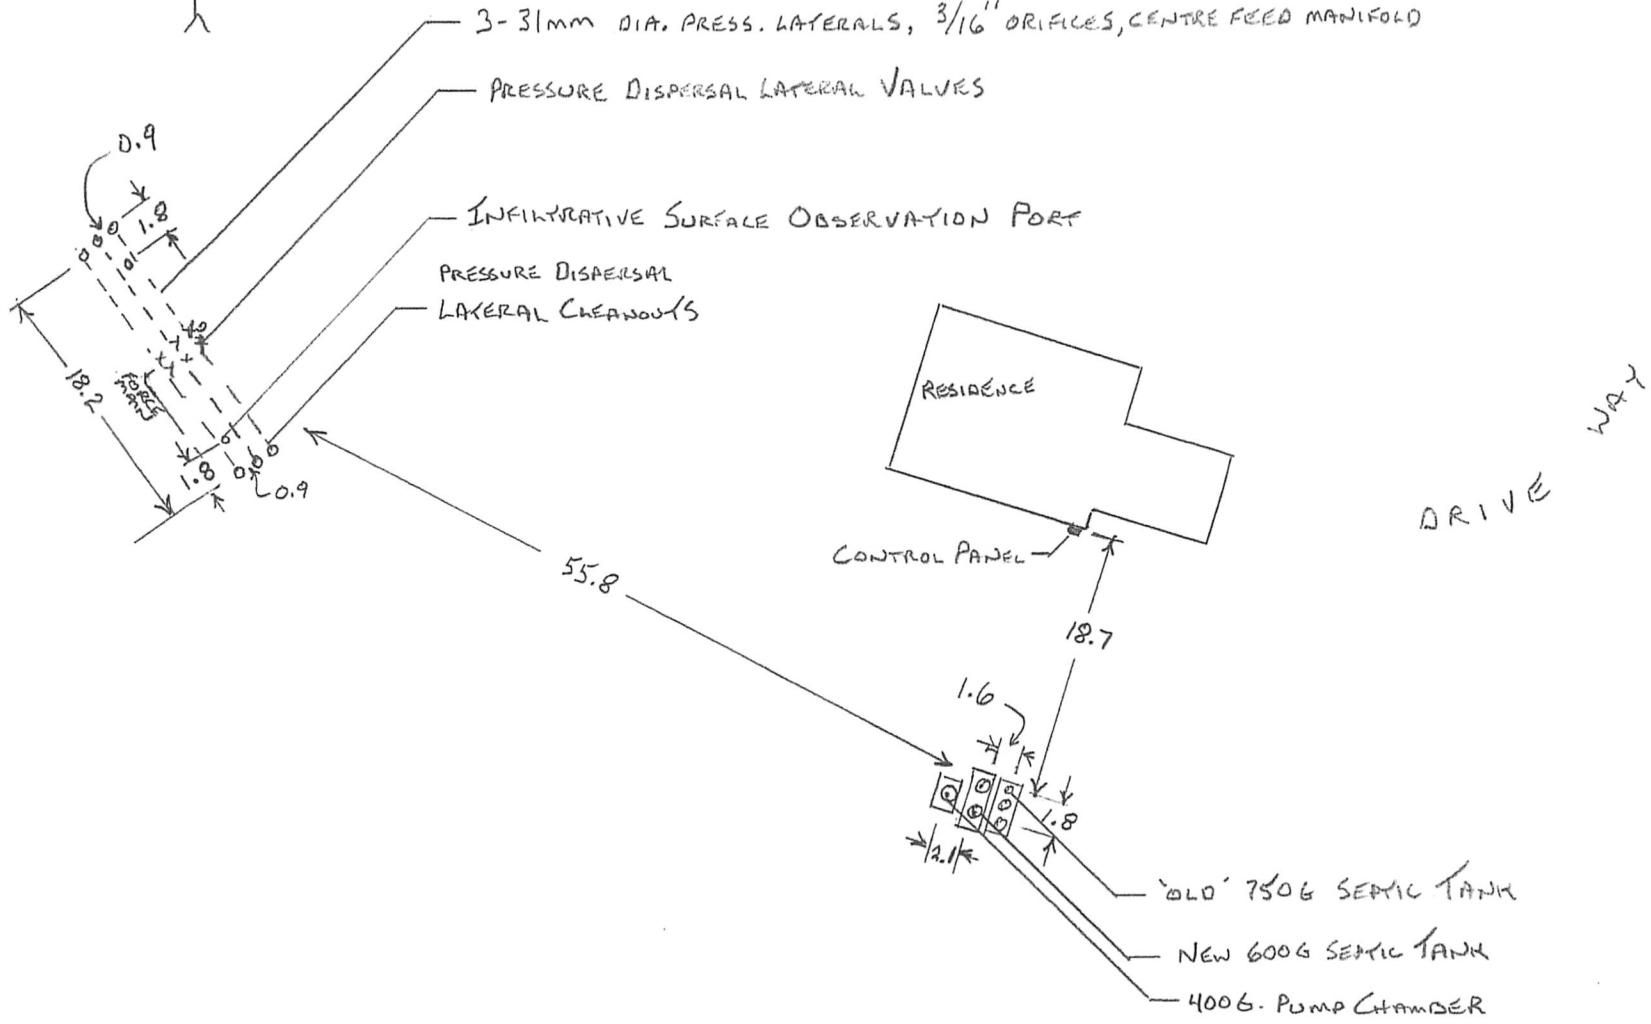

# Record Drawing (As Built) of Onsite Wastewater System

Client: [REDACTED] Location: [REDACTED]  
Drawn By/Planner: [REDACTED] Date: February 1, 2015 Scale: 1:500

All dimensions are in metres unless otherwise noted



SCALE BAR

